

WINDIMURRA VANADIUM

DOCUMENT REVIEW

1 ☒ Approved



2 ☐ Approved as noted - revise and resubmit

3 ☐ Not approved - revise and resubmit

4 ☐ Review not required

Approval does not relieve contractor from full compliance with contractual obligations

Date 18/08/2008 Sign [Signature]

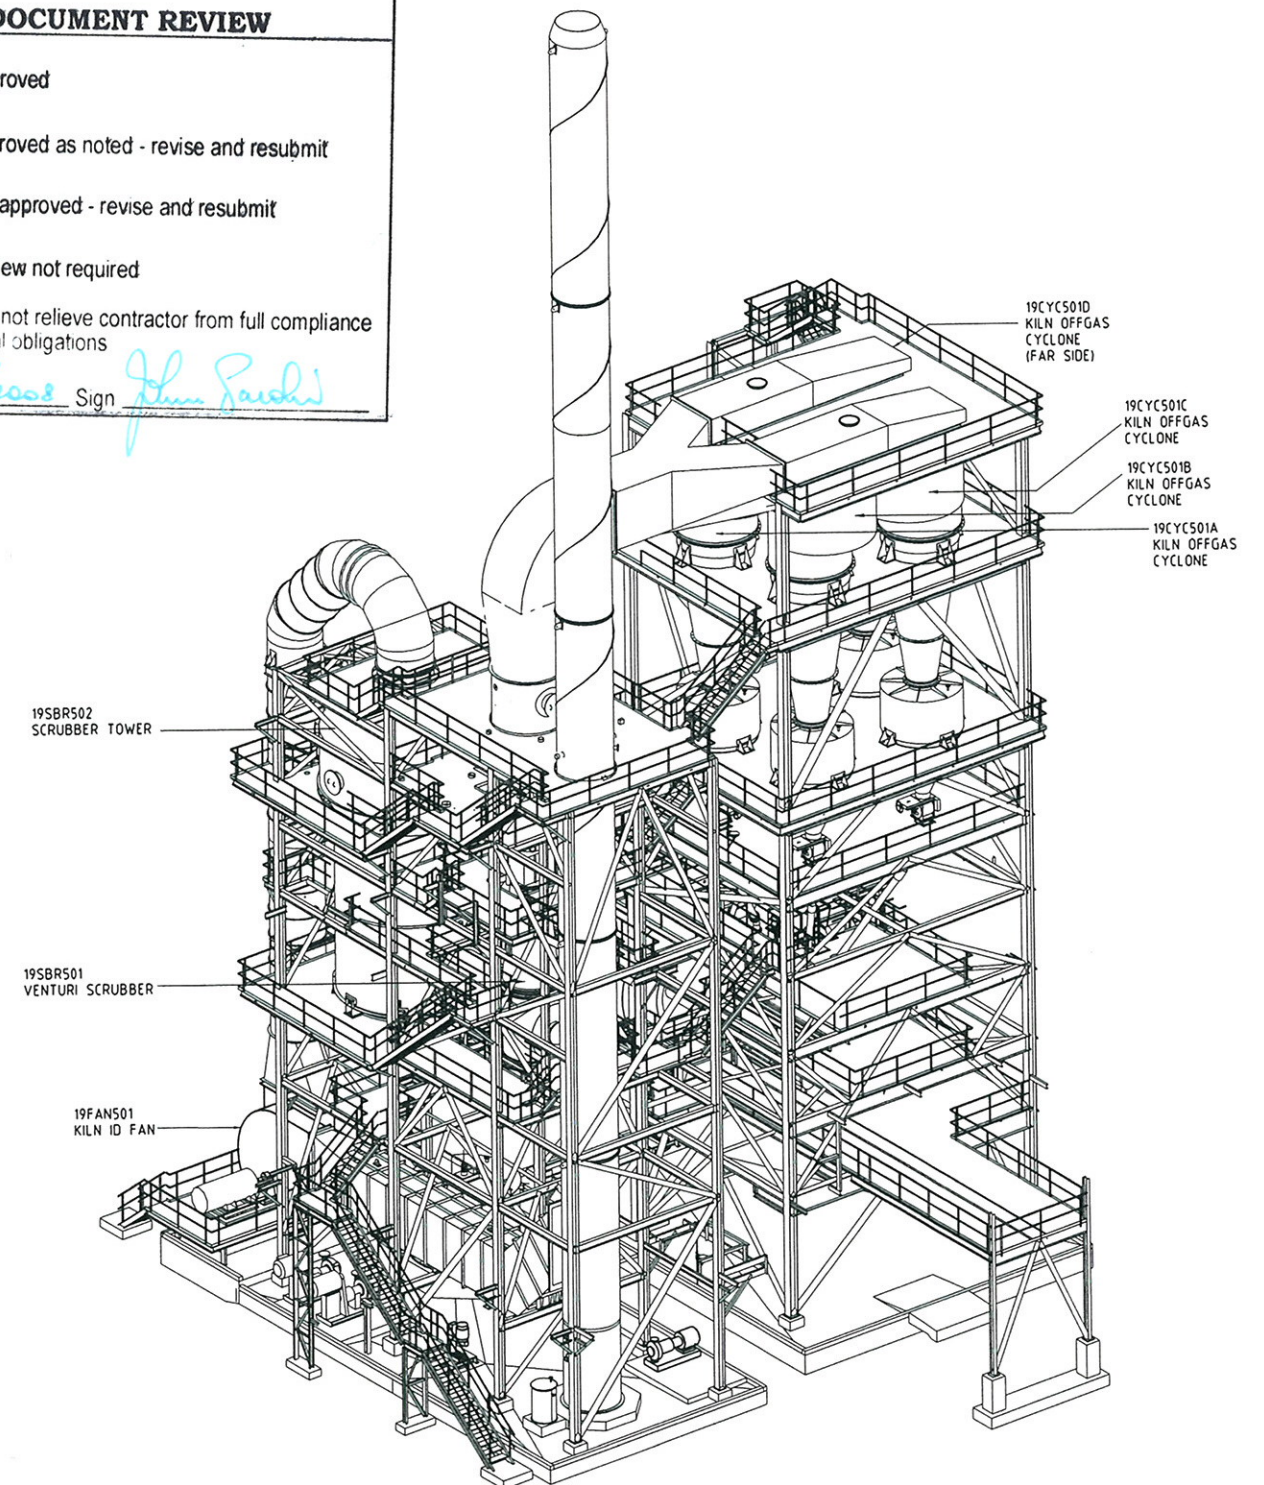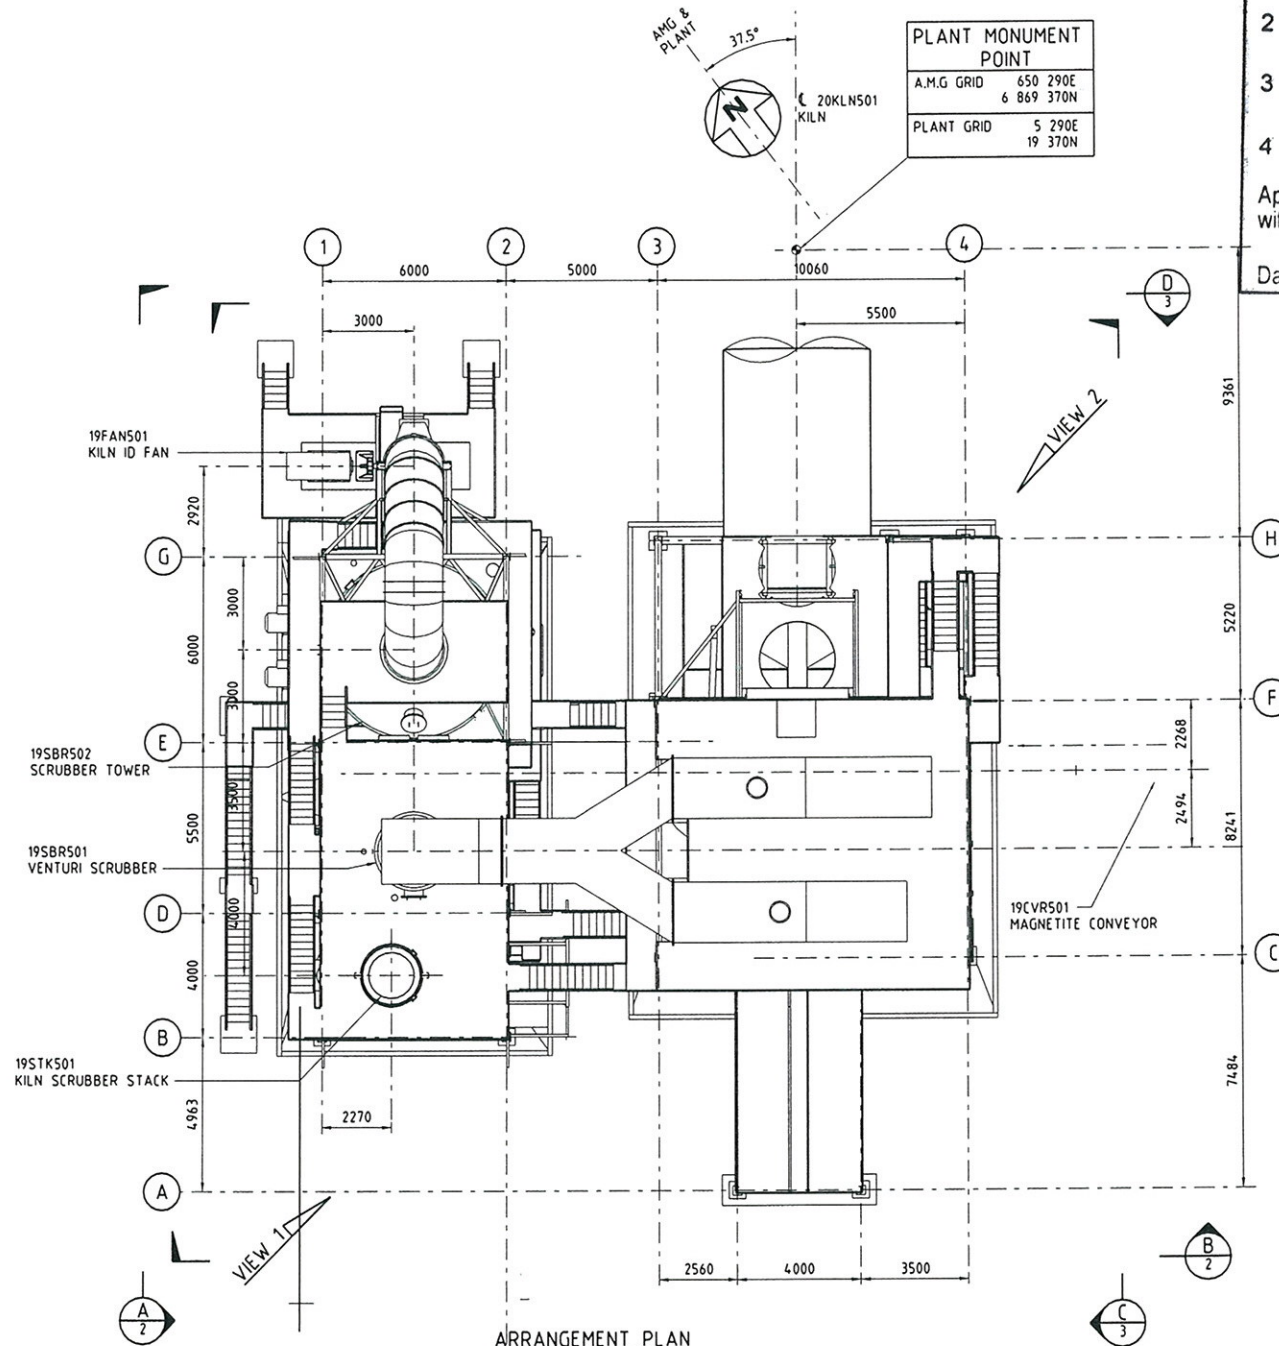

ARRANGEMENT 3D VIEW 1

PROTEUS DRG No. 06033-DM-080

No	REF. DRG. No.	TITLE	REV	BY	DATE	DESCRIPTION	CHK'D	APP'D	REV	BY	DATE	DESCRIPTION	CHK'D	APP'D
			0	JM	28.07.08	ISSUED FOR CONSTRUCTION								
			E	EW	25.07.08	ISSUED FOR CLIENT APPROVAL	JM	B/G						
			O	AB	09.11.07	RE-ISSUED FOR CLIENT REVIEW	KN	B/G						
3	6033-19-M-1011	GENERAL ARRANGEMENT - ELEVATIONS - SHEET 2	C	AB	28.09.07	ISSUED FOR CLIENT REVIEW	KN	B/G						
2	6033-19-M-1010	GENERAL ARRANGEMENT - ELEVATIONS - SHEET 1	B	AB	20.08.07	ISSUED FOR SCRUBBER TENDER	KN	B/G						
1	6033-19-M-1006	GENERAL ARRANGEMENT - PLAN AND 3D VIEW - SHEET 2	A	AB	07.05.07	ISSUED FOR STAGE 1 EPCM REPORT	KN	B/G						

CLIENT



proteus engineers
consulting engineers • project managers
ph (08) 9481 3200 • fax (08) 9481 2249
email proteus@proteuseng.com.au

This drawing must not be copied, reproduced, or used in any form or for any purpose other than expressly intended without written approval of PROTEUS ENGINEERS.
Proteus Consultants Pty Ltd ACN 909 902 129 4/151 Proteus Unit Trust trading as Proteus Engineers

BY	DATE
DRAWN A.BORNKHOFF	02.04.07
CHK'D K. NORMAN	25.07.08
DES.N I. POOL	02.04.07
CHK'D D. TREMAN	25.07.08
APP'D B. GILLIS	25.07.08

TITLE
WINDIMURRA VANADIUM PROJECT
AREA 19 - MAGNETITE
GENERAL ARRANGEMENT
PLAN AND 3D VIEW - SHEET 1

SCALE
1:100

B1

DRG. No.
6033-19-M-1005

REV.
0