

WINDIMURRA VANADIUM

DOCUMENT REVIEW

1 ☒ Approved


2 ☐ Approved as noted - revise and resubmit

3 ☐ Not approved - revise and resubmit

4 ☐ Review not required

Approval does not relieve contractor from full compliance with contractual obligations

Date 18/08/08 Sign John Parole

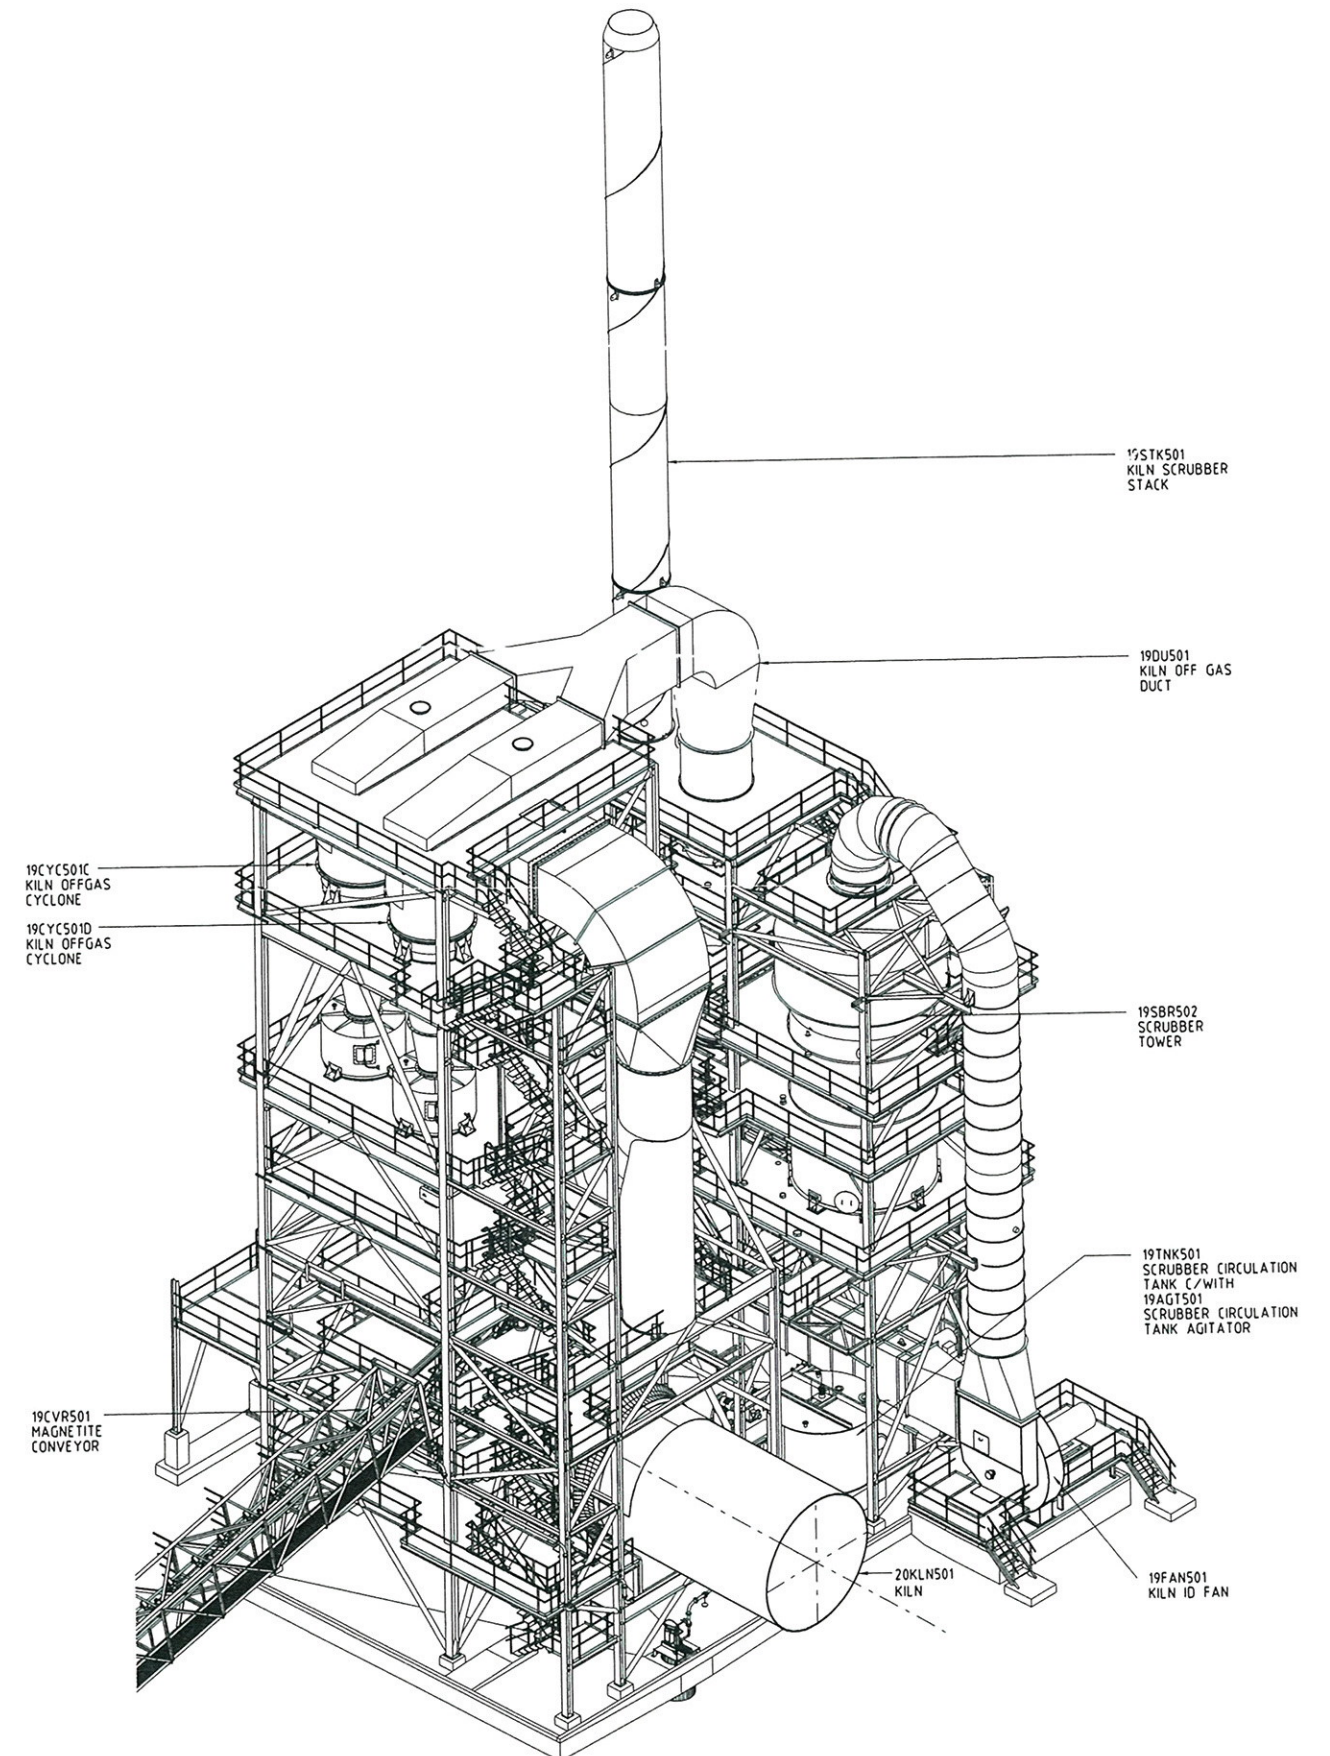

ARRANGEMENT 3D VIEW 2

PROTEUS DRG No. 06033-DM-081

No	REF. DRG. No.	TITLE	REV	BY	DATE	DESCRIPTION	CHK'D	APP'D	REV	BY	DATE	DESCRIPTION	CHK'D	APP'D
			0	JM	28.07.08	ISSUED FOR CONSTRUCTION								
			0	EW	25.07.08	ISSUED FOR CLIENT APPROVAL	KN	BJS						
			C	AB	09.11.07	RE-ISSUED FOR CLIENT REVIEW	KN	BJS						
			B	AB	28.09.07	ISSUED FOR CLIENT REVIEW	KN	BJS						
1	6033-19-M-1005	GENERAL ARRANGEMENT - PLAN AND 3D VIEW - SHEET 1	A	AB	20.08.07	ISSUED FOR SCRUBBER TENDER	KN	BJS						



proteus engineers
consulting engineers • project managers
ph (08) 9481 3200 • fax (08) 9481 2249
email proteus@proteuseng.com.au

BY	DATE
DRAWN: A BORNHAY	19.08.07
CHK'D: K NORMAN	25.07.08
DES'N: I POOLE	18.08.07
CHK'D: D TREHAN	25.07.08
APP'D: B GILLIS	25.07.08

TITLE
WINDIMURRA VANADIUM PROJECT
AREA 19 - MAGNETITE
GENERAL ARRANGEMENT
PLAN AND 3D VIEW - SHEET 2

SCALE	B1	DRG. No.	REV.
1:100		6033-19-M-1006	0