
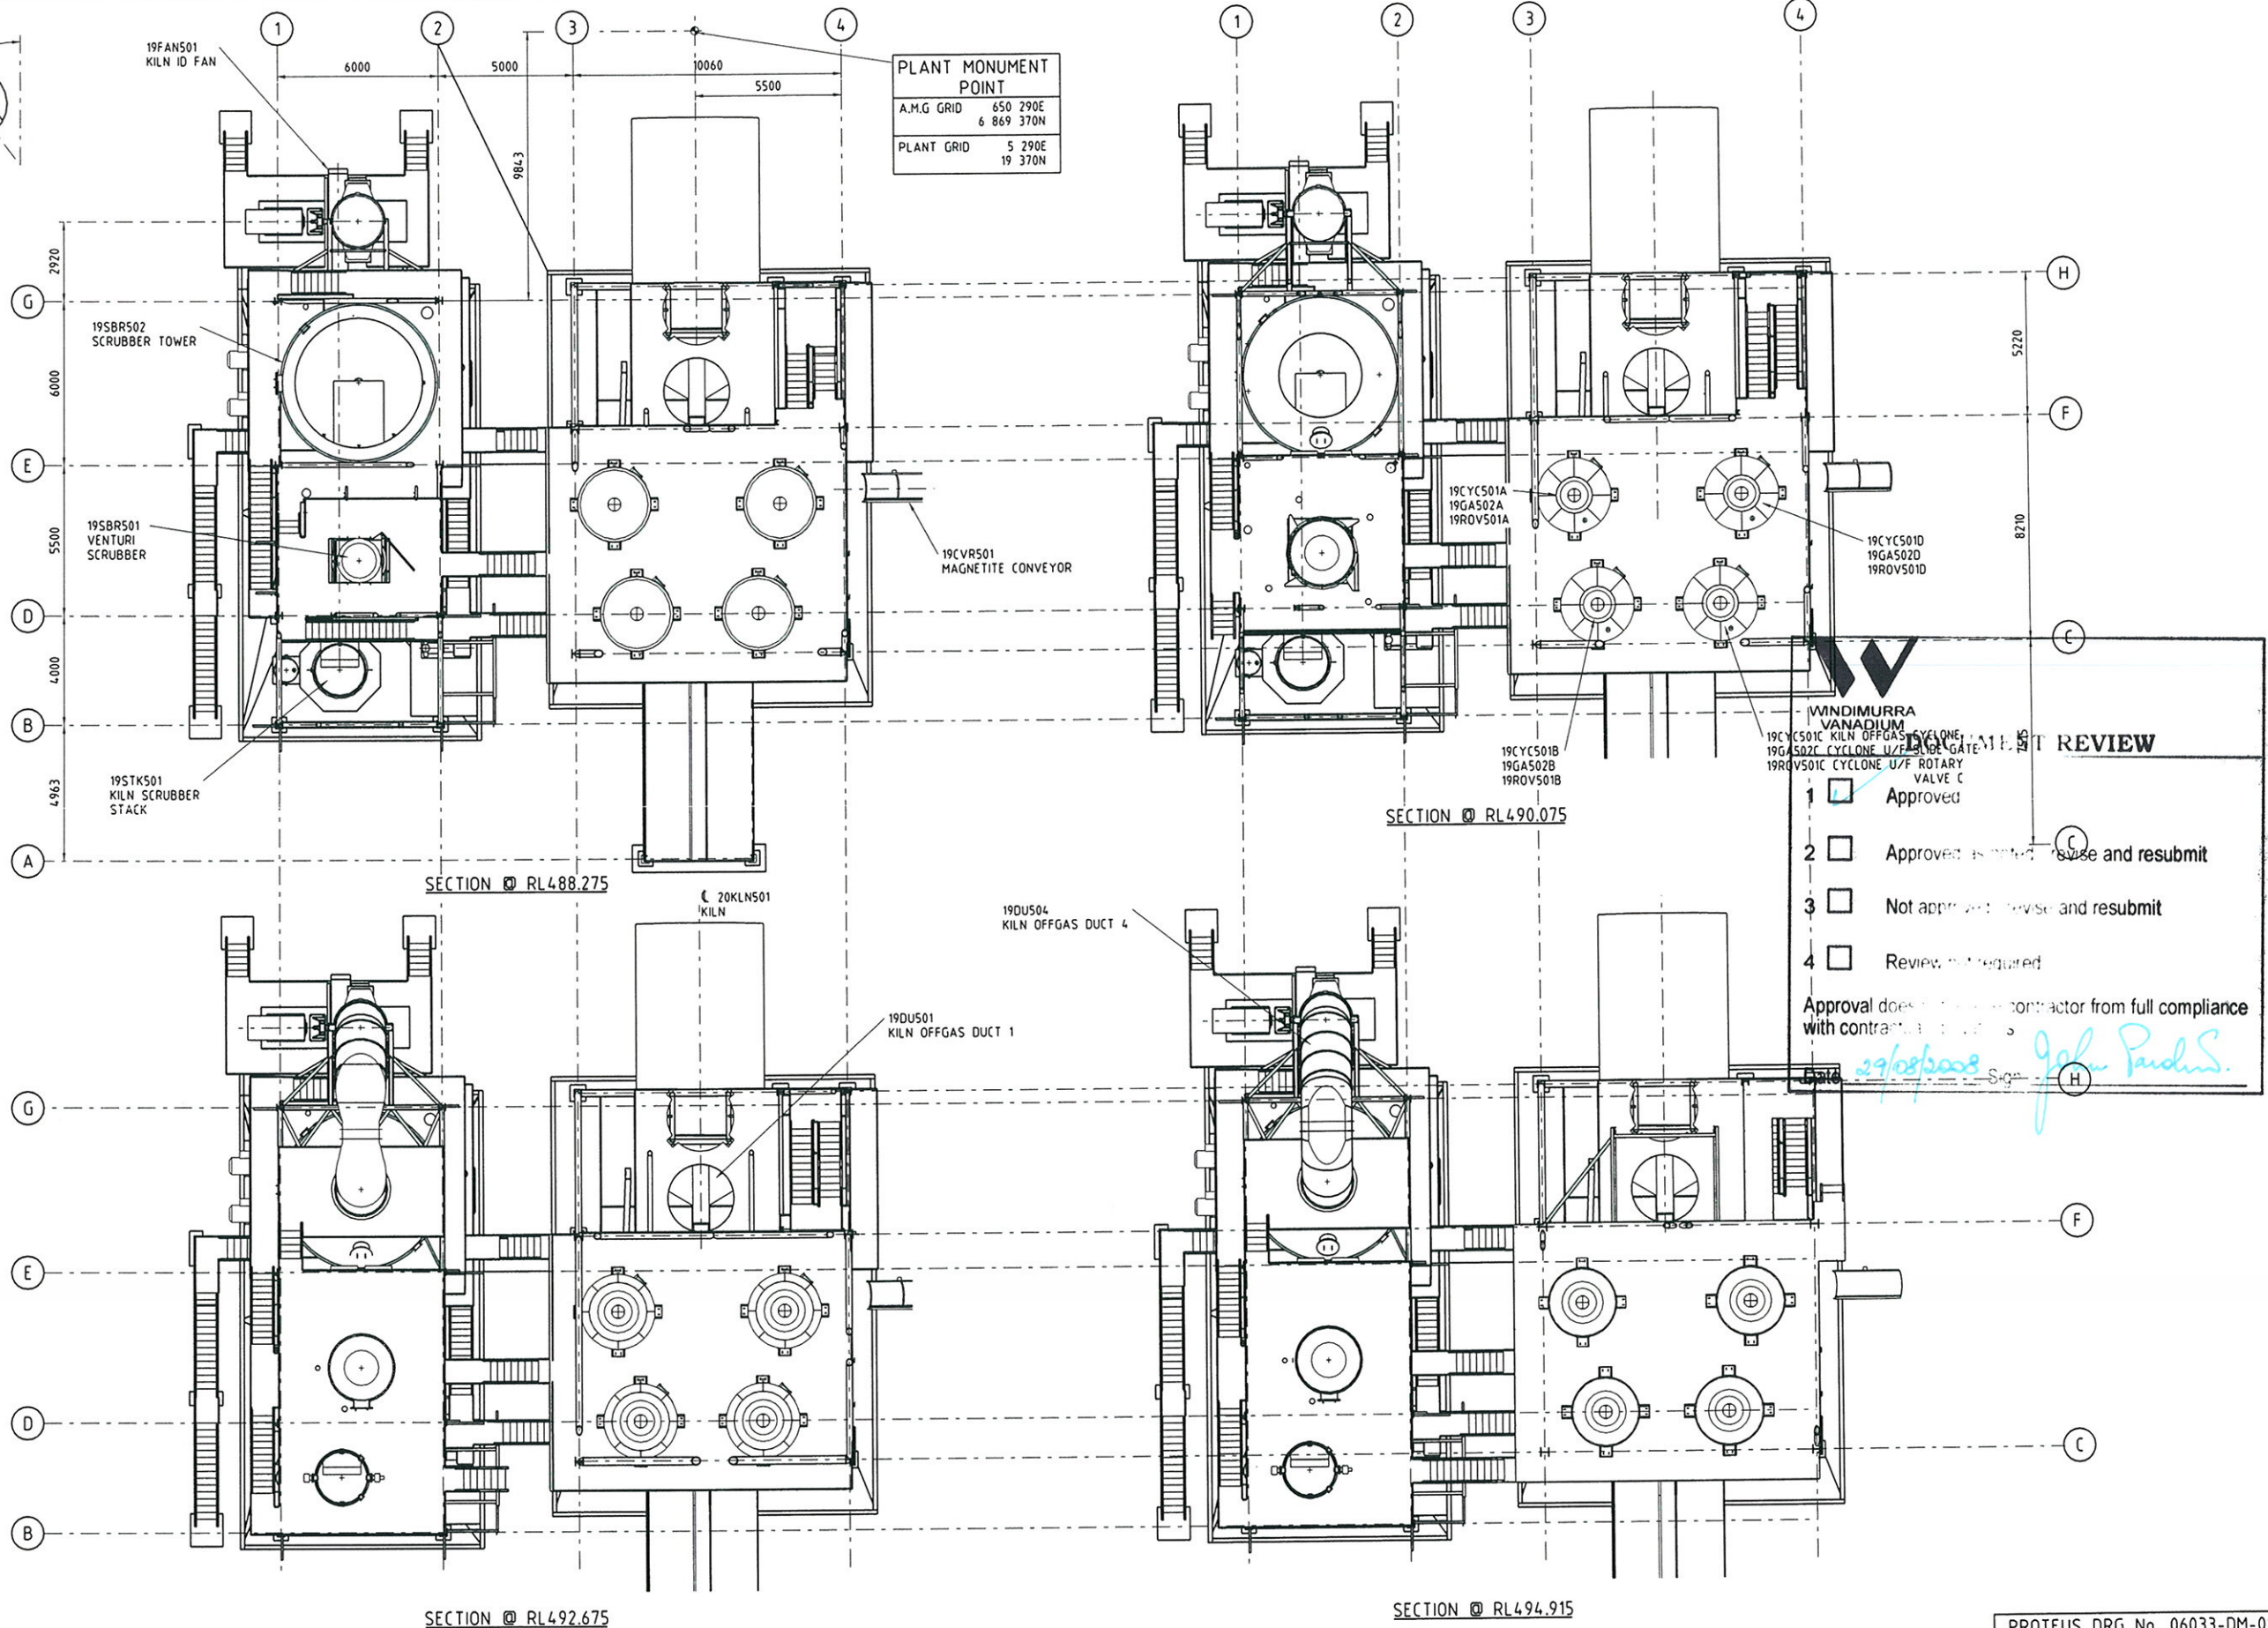


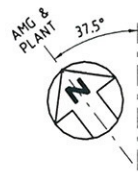

PLANT MONUMENT
POINT
A.M.G GRID 650 290E
6 869 370N
PLANT GRID 5 290E
19 370N

WINDIMURRA
VANADIUM
AREA 19 - MAGNETITE
GENERAL ARRANGEMENT
SECTION PLANS - SHEET 2

- 1 ☒ Approved
- 2 ☐ Approved as noted - revise and resubmit
- 3 ☐ Not approved - revise and resubmit
- 4 ☐ Review not required

Approval does not release contractor from full compliance with contract conditions

Date: 29/08/2008
Signature: John Paulsen

No	REV	BY	DATE	DESCRIPTION	CHK'D	APP'D
4	0	JM	21.08.08	ISSUED FOR CONSTRUCTION	KN	BIG
3	0	JM	21.08.08	ISSUED FOR CLIENT APPROVAL	KN	BIG
2	0	JM	21.08.08	ISSUED FOR CLIENT APPROVAL	KN	BIG
1	0	AJB	05.08.08	ISSUED FOR INTERNAL REVIEW	KN	BIG



proteus engineers
consulting engineers • project managers
ph (08) 9481 3200 • fax (08) 9481 2249
email proteus@proteuseng.com.au

BY	DATE
DRAWN: ABREWSTER	04.07.08
CHK'D: K. NORMAN	04.07.08
DES'N: L. POOLE	04.07.08
CHK'D: D. TREHAR	04.07.08
APP'D: B. GILLIS	04.07.08

TITLE WINDIMURRA VANADIUM PROJECT AREA 19 - MAGNETITE GENERAL ARRANGEMENT SECTION PLANS - SHEET 2			
SCALE 1:100	B1	DRG. No. 6033-19-M-1024	REV. 0