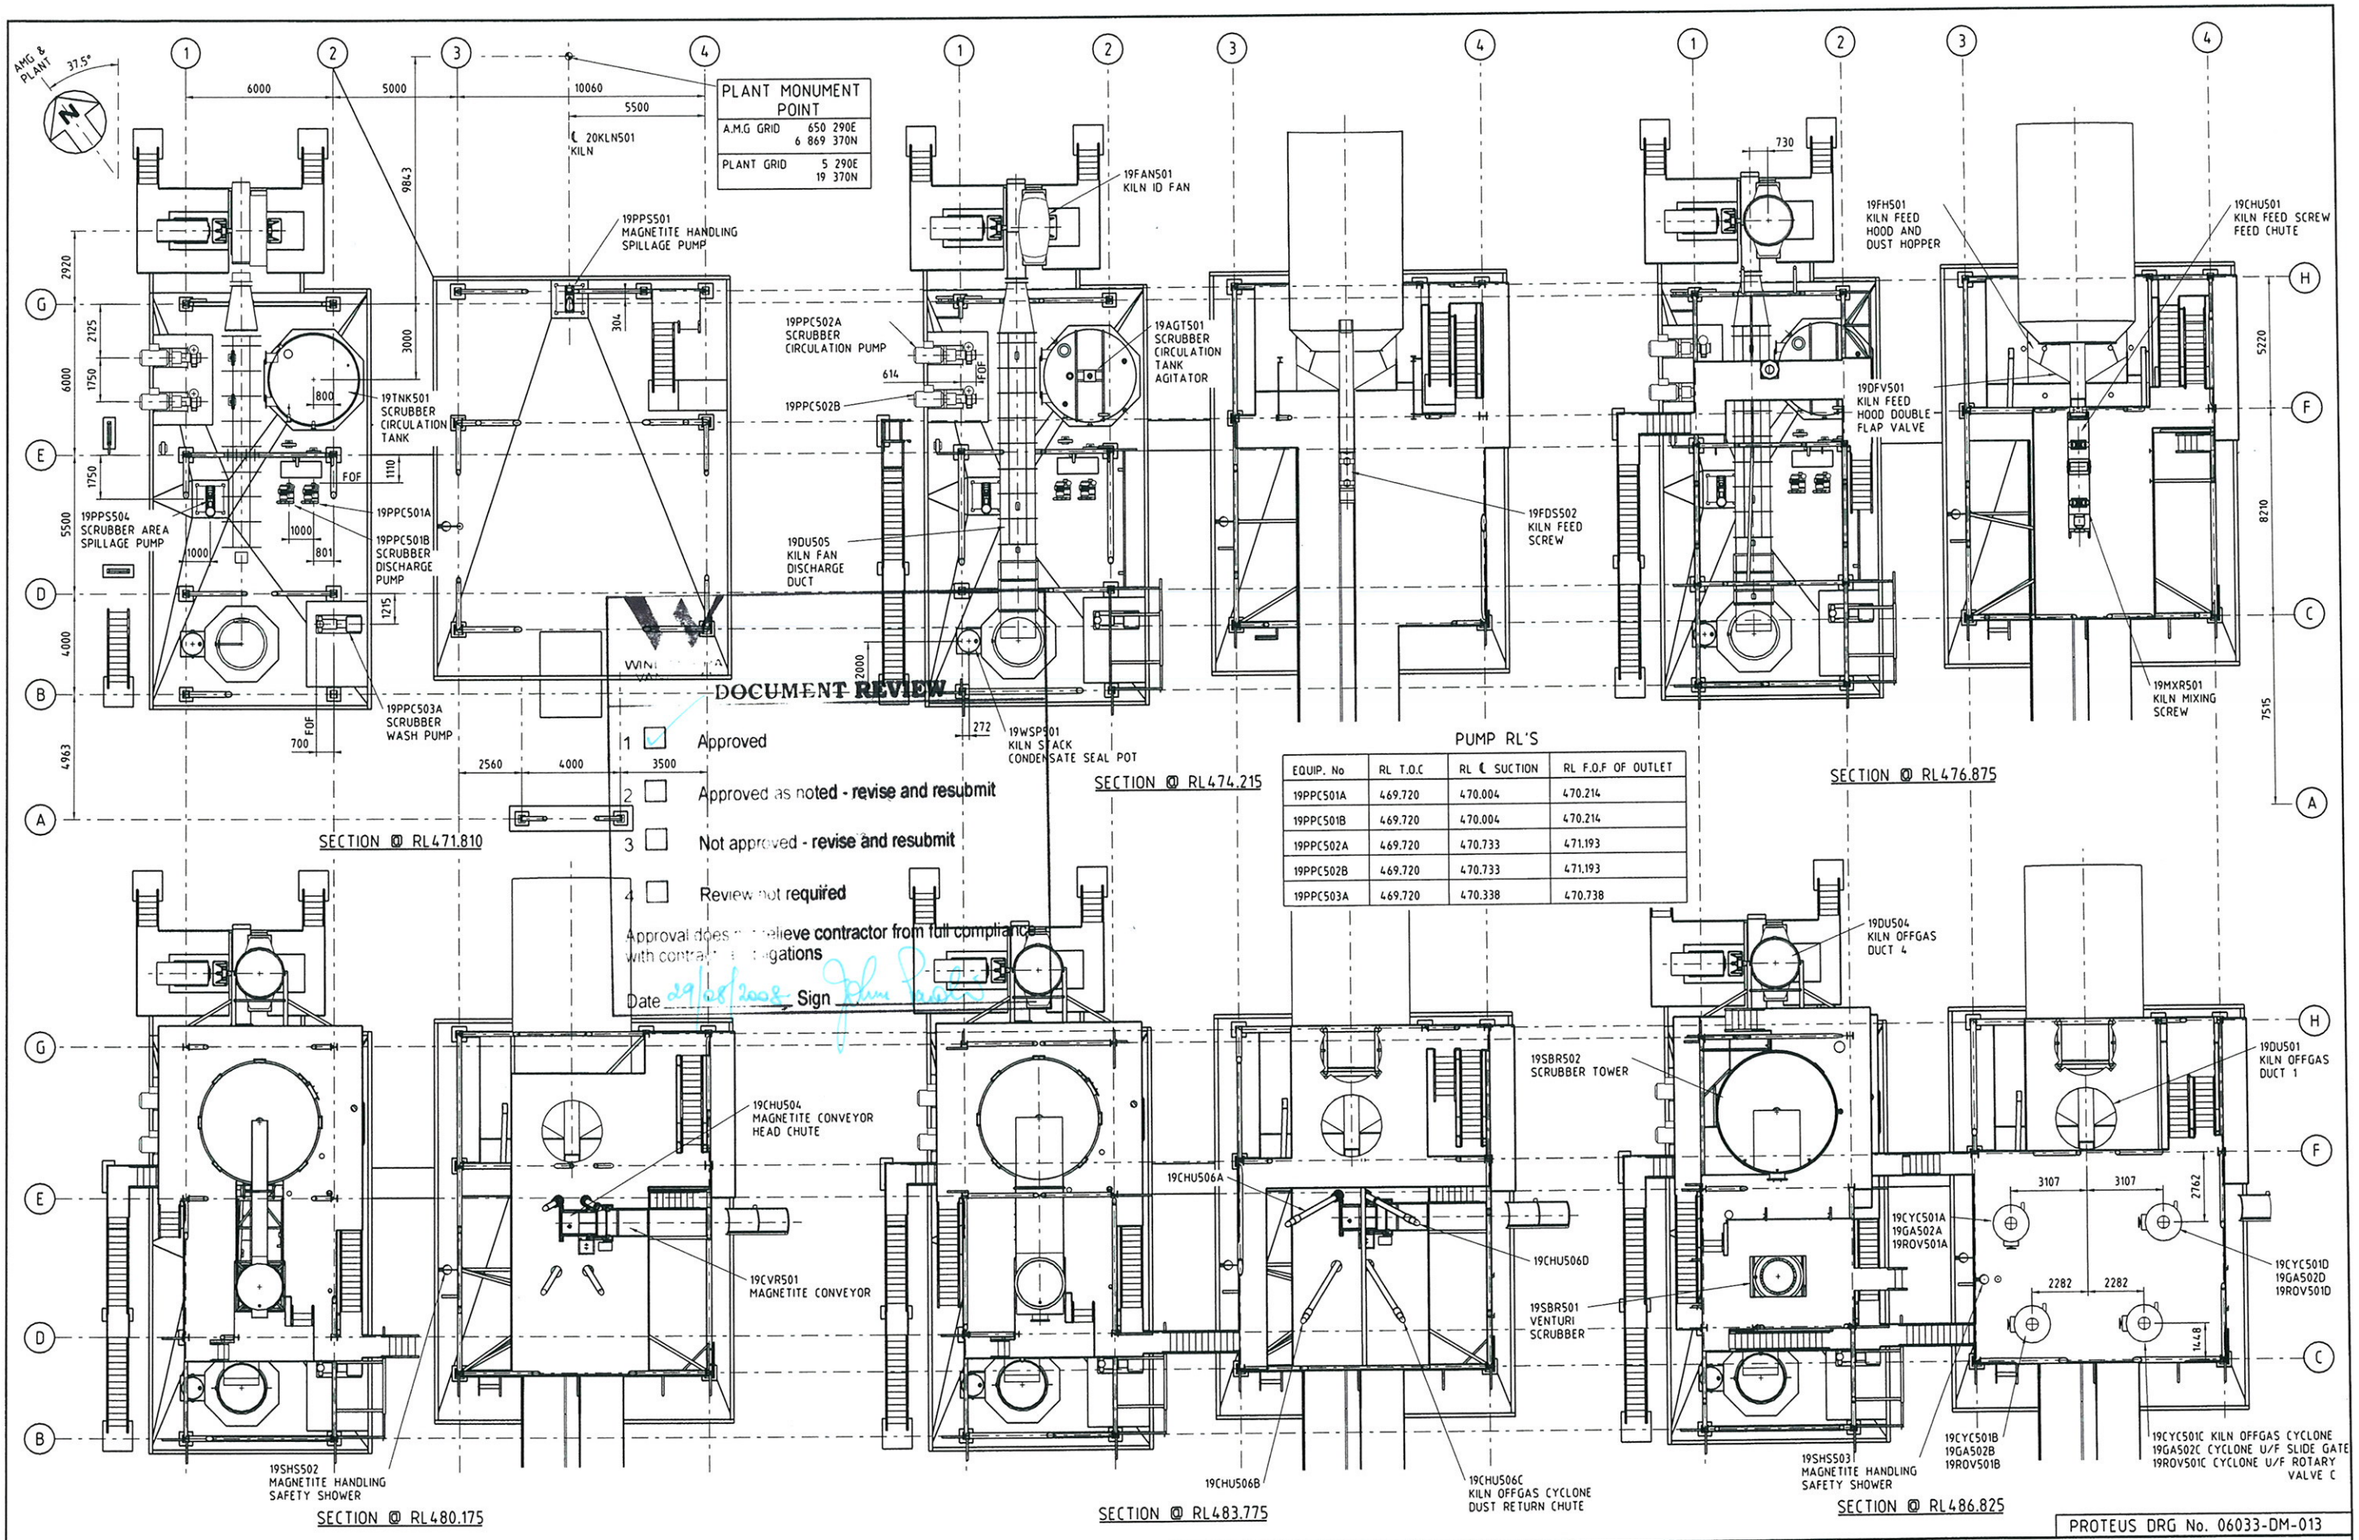

PUMP RL'S

EQUIP. No	RL T.O.C	RL ℄ SUCTION	RL F.O.F OF OUTLET
19PPC501A	469.720	470.004	470.214
19PPC501B	469.720	470.004	470.214
19PPC502A	469.720	470.733	471.193
19PPC502B	469.720	470.733	471.193
19PPC503A	469.720	470.338	470.738

DOCUMENT REVIEW

1 ☑ Approved
2 ☐ Approved as noted - revise and resubmit
3 ☐ Not approved - revise and resubmit
4 ☐ Review not required

Approval does not relieve contractor from full compliance with contract obligations

Date 29/08/2008 Sign

PROTEUS DRG No. 06033-DM-013

No	REF. DRG. No.	TITLE	REV	BY	DATE	DESCRIPTION	CHK'D	APP'D
4	6033-19-M-1024	GENERAL ARRANGEMENT - SECTION PLANS - SHEET 2						
3	6033-19-M-1011	GENERAL ARRANGEMENT - ELEVATIONS - SHEET 2	0	JM	21.08.08	ISSUED FOR CONSTRUCTION	KN	BJG
2	6033-19-M-1010	GENERAL ARRANGEMENT - ELEVATIONS - SHEET 1	B	JM	21.08.08	ISSUED FOR CLIENT APPROVAL	KN	BJG
1	6033-19-M-1006	GENERAL ARRANGEMENT- PLAN AND 3D VIEW - SHEET 2	A	AJB	05.08.08	ISSUED FOR INTERNAL REVIEW	KN	BJG

REV	BY	DATE	DESCRIPTION	CHK'D	APP'D

CLIENT: WINDIMURRA VANADIUM

proteus engineers
consulting engineers • project managers
ph (08) 9481 3200 • fax (08) 9481 2249
email proteus@proteuseng.com.au

This drawing must not be copied or reproduced in any form or used for any purpose other than originally intended without written approval of PROTEUS ENGINEERS
Proteus Consultants Pty Ltd ACN 009 102 329 A.I.T.F Proteus Unit Trust trading as Proteus Engineers

	BY	DATE
DRAWN	A.BREWSTER	04.07.08
CHK'D.	K. NORMAN	04.07.08
DES'N.	I. POOLE	04.07.08
CHK'D.	D. TREMAIN	04.07.08
APP'D.	B. GILLIS	04.07.08

TITLE
WINDIMURRA VANADIUM PROJECT
AREA 19 - MAGNETITE
GENERAL ARRANGEMENT
SECTION PLANS - SHEET 1

SCALE		DRG. No.	REV.
1:100	B1	6033-19-M-1023	0

u:\windimurra vanadium\06033 windimurra vanadium project\Mechanical\Area 19 Magnetite\6033-19-M-1023.dgn
11:17:24 AM21/08/2008